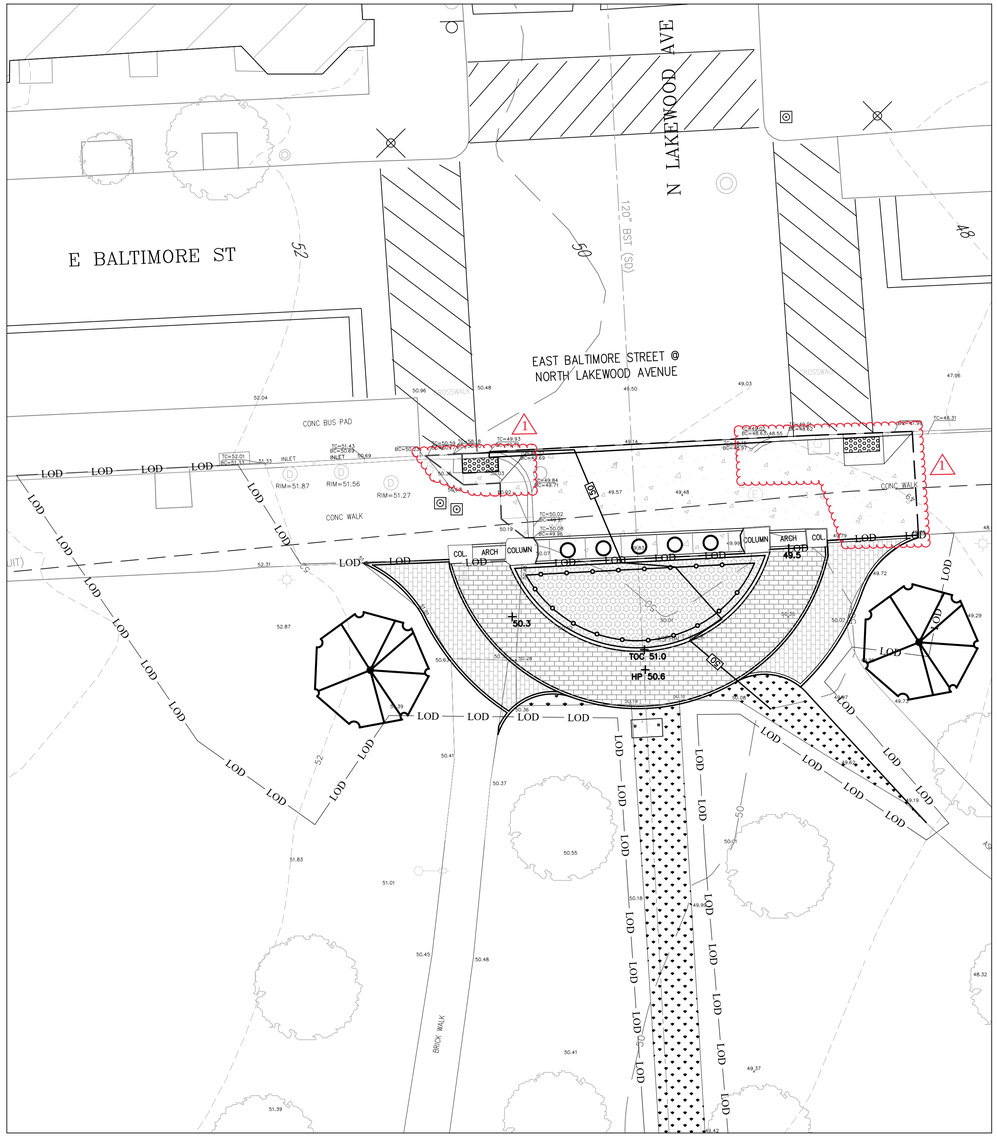

1 L2.1 **GRADING PLAN**
SCALE: 1" = 10'-0"

0' 10' 20' 30'

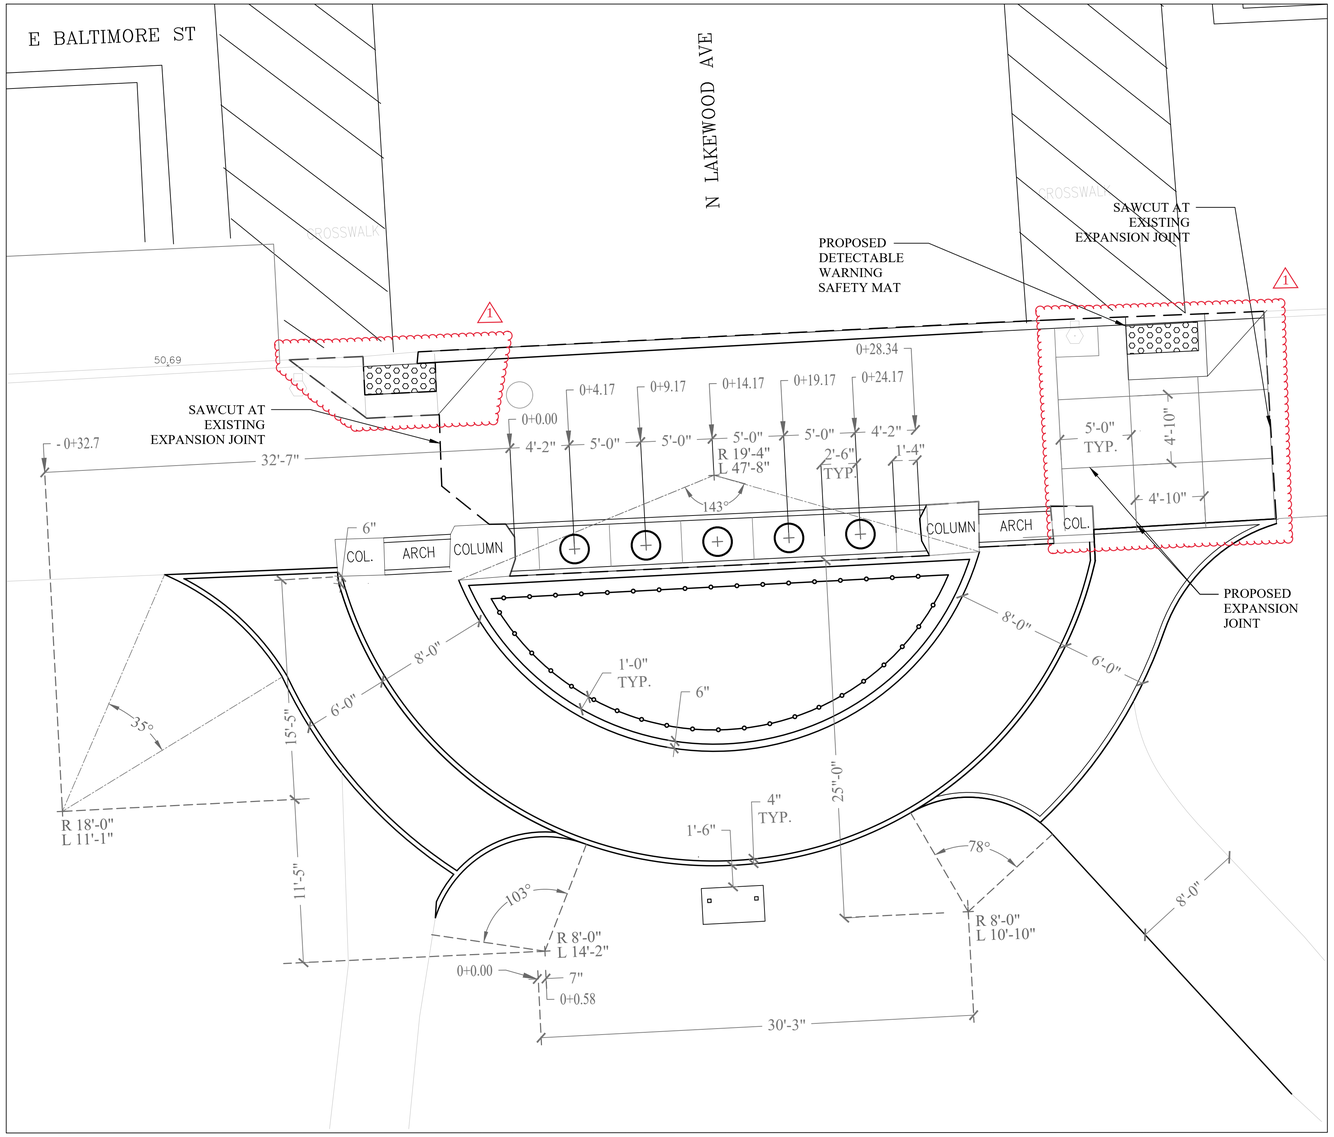

2 L2.1 **LAYOUT PLAN**
SCALE: 1" = 5'-0"

0' 5' 10' 15'

LEGEND

- LOD — Proposed Limits of Disturbance
- Proposed Wayfinding Sign
- 50 Proposed Contour
- +50.5 Proposed Spot Elevation
- Proposed 18" Hairpin Fence
- Proposed Bollards
- Proposed Concrete Sidewalk
- Proposed Asphalt Paver
- Proposed Asphalt Paver
- Proposed Tree
- Community Garden Planting Bed

PATTERSON PARK ENTRANCE IMPROVEMENT

100 SOUTH LINWOOD AVENUE, 21224
BLOCK 1704, LOT 001, WARD 01, SECTION 01

REVISIONS		
NO.	DATE	COMMENTS
1	04/09/2021	PER DOT REVIEW COMMENTS FOR PERMITS.

CITY OF BALTIMORE
DEPARTMENT OF RECREATION AND PARKS

N LAKEWOOD AVENUE ENTRANCE
GRADING AND LAYOUT PLAN

SCALE AS SHOWN DATE November 2020

DRAWN BY J. Zhai
DESIGNED BY J. Zhai
CHECKED BY V. McGuire

CONTRACT NO. RP20809
SHEET NO. L-2.1

SHEET 3 OF 6